




Key
 Removal of Disabled
 Parking Bay 

© Crown Copyright. Licence: 100020999.
 Brighton & Hove City Council, 2012.

Address: Opposite 6 Brunswick
 Square, Hove

Reason: Bay being removed as no
 longer required

CITY INFRASTRUCTURE	PARKING INFRASTRUCTURE
Scale : N.T.S.	 Brighton & Hove
Date : March 2013	
Drawn : DLA	Drawing Number : B&H_DPB-050-2013

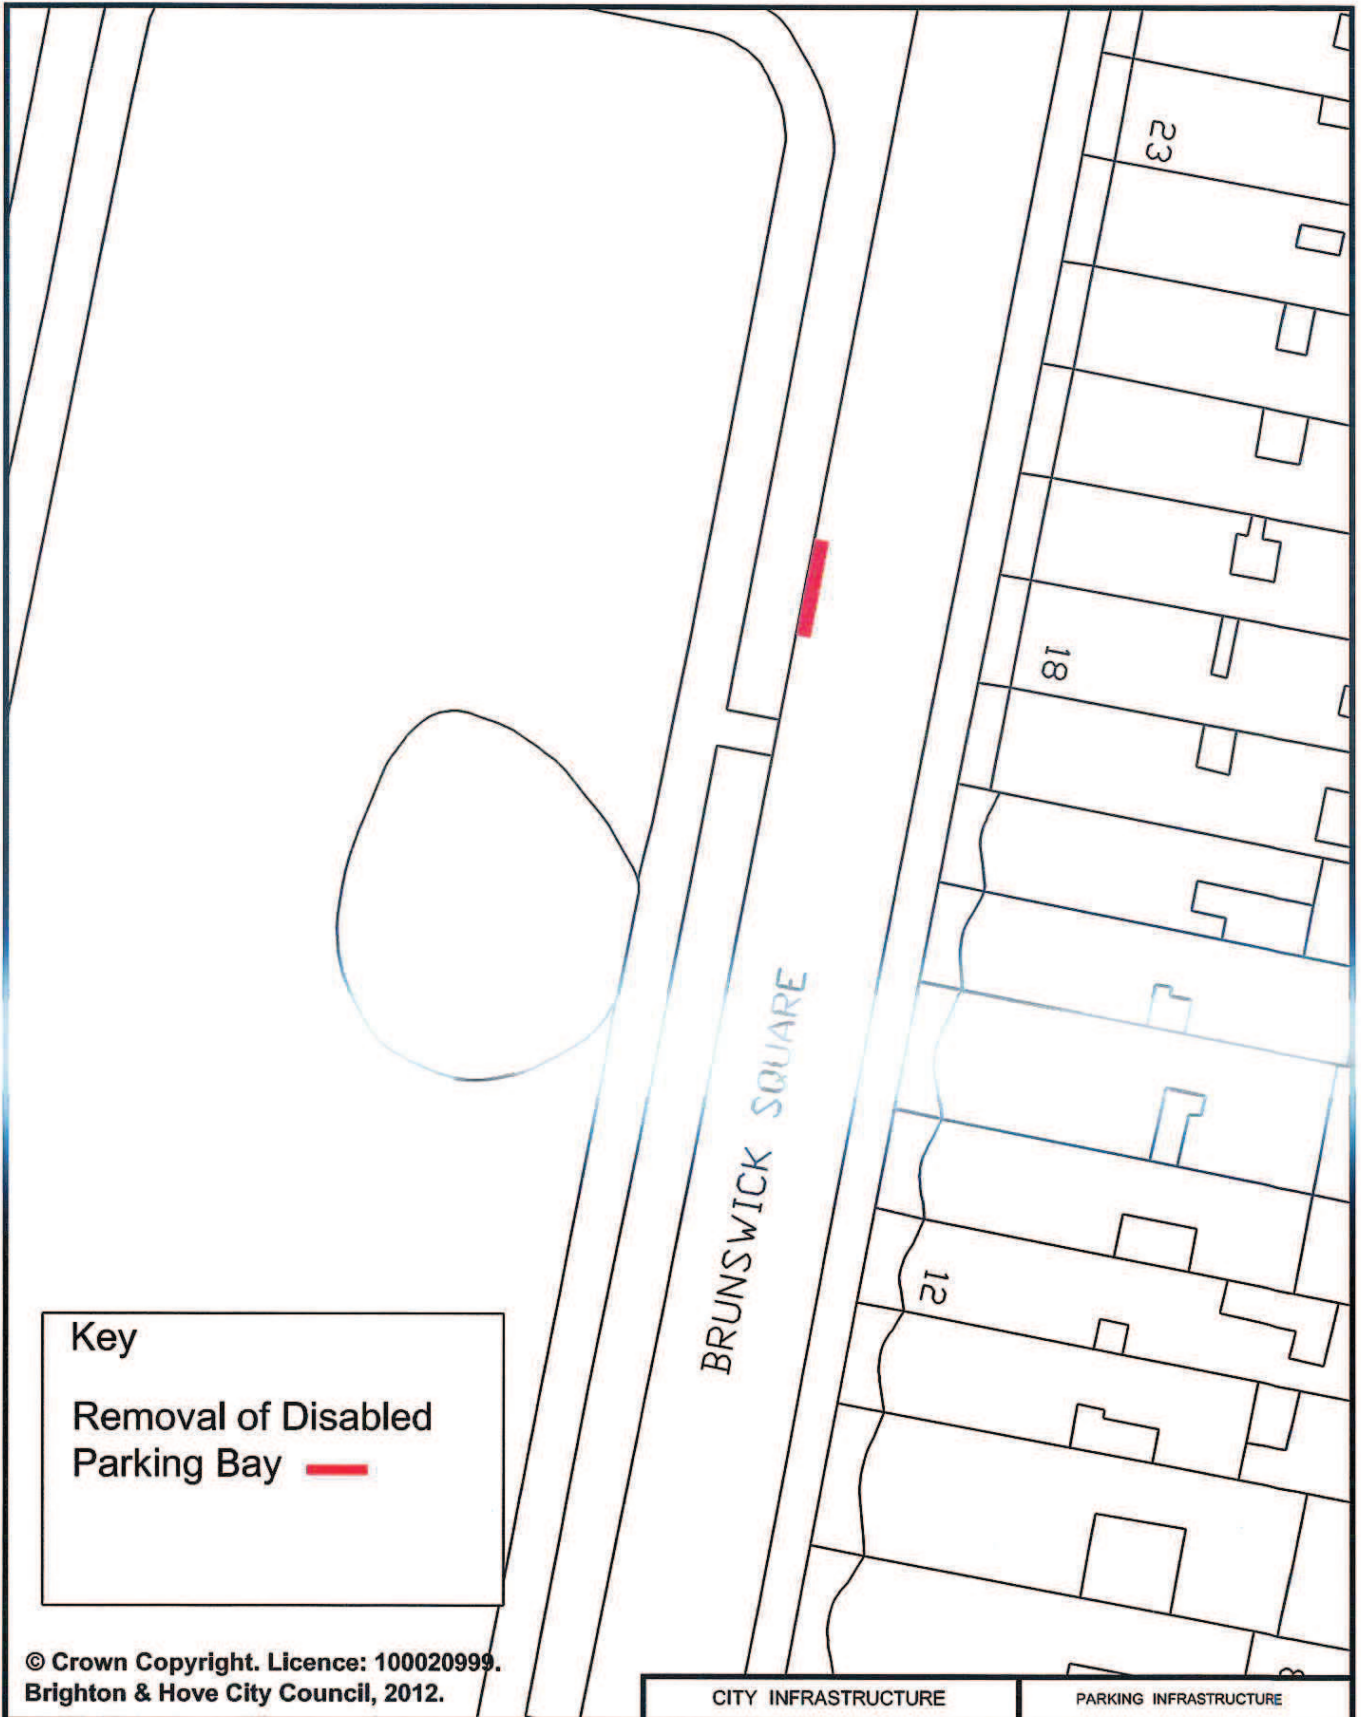


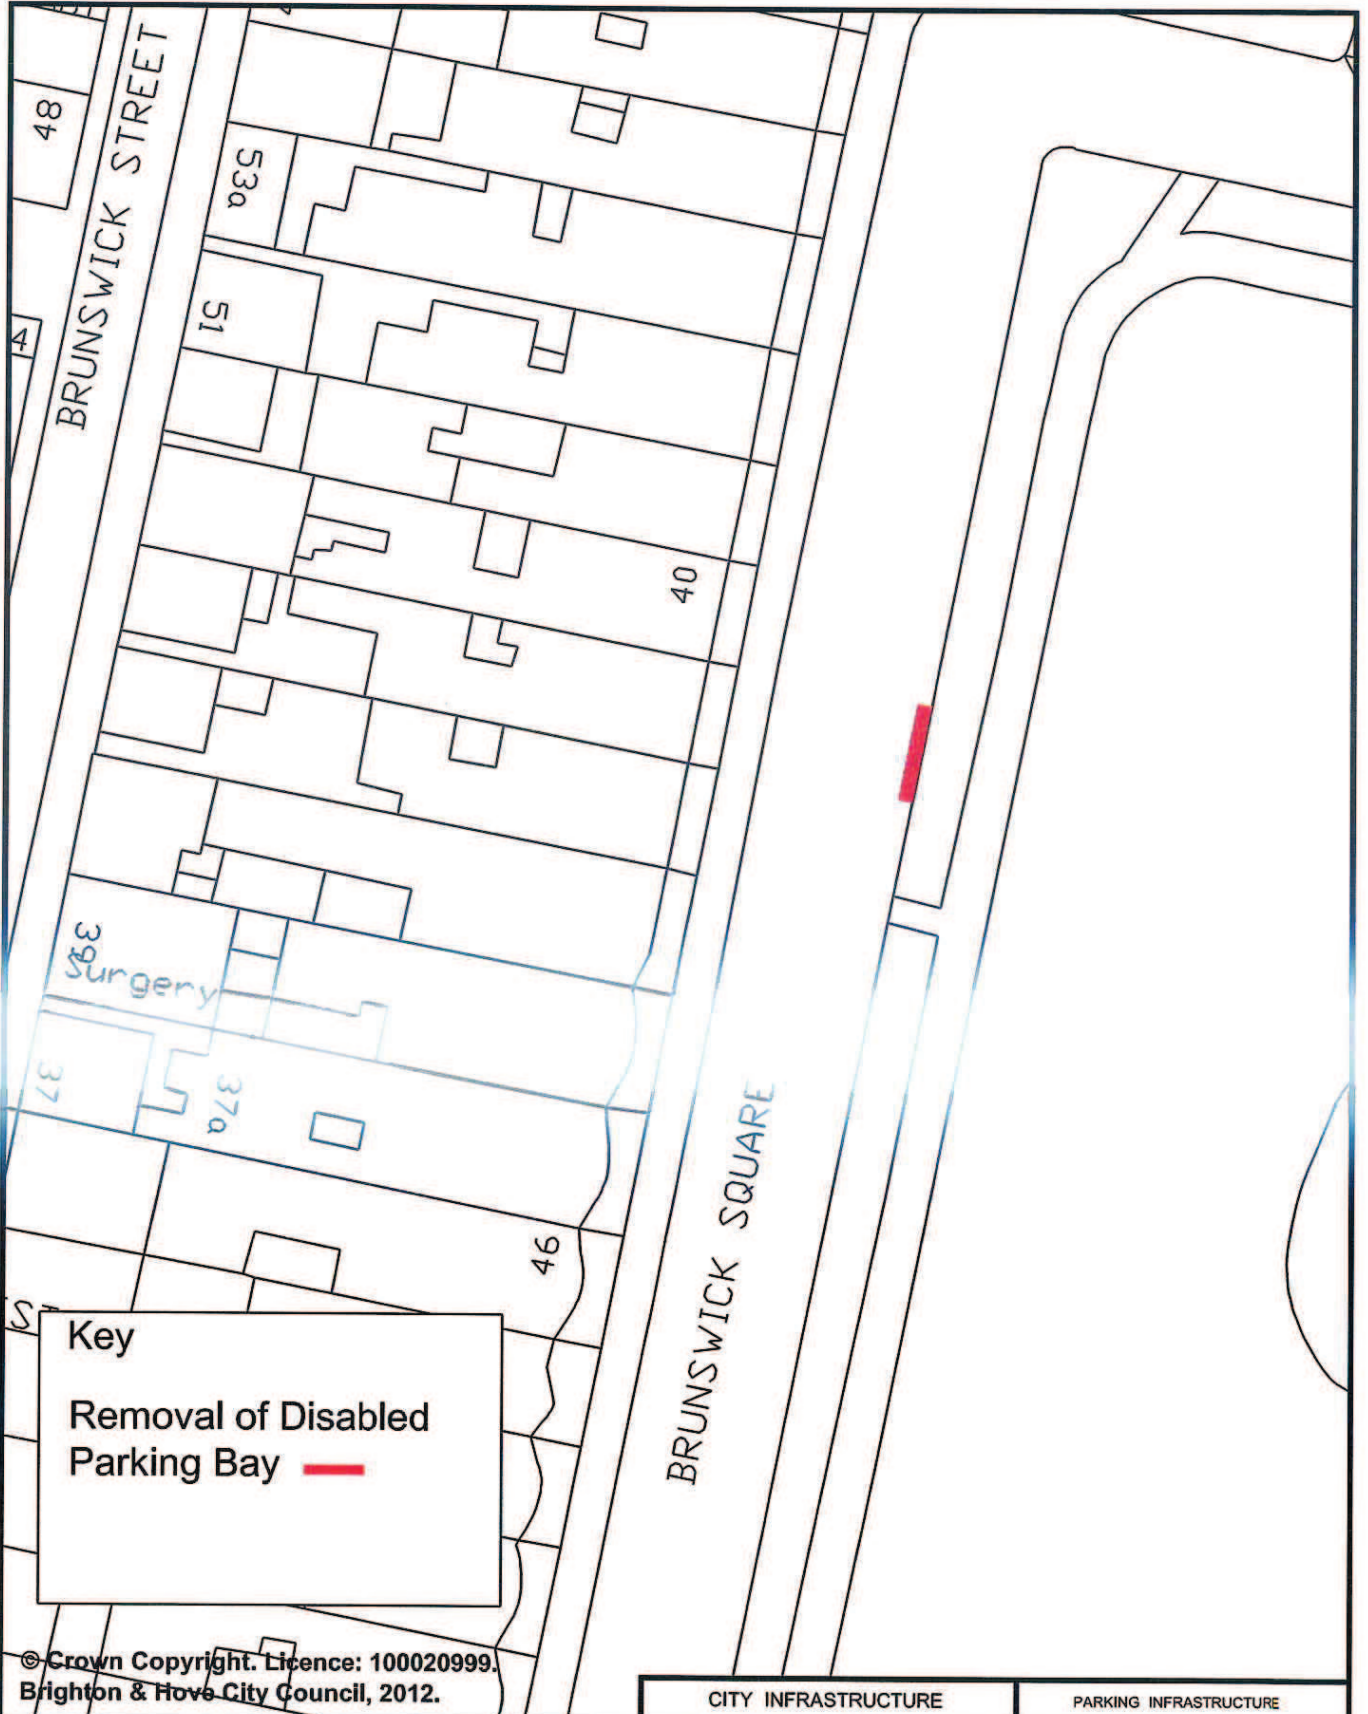
Key
 Removal of Disabled
 Parking Bay —

© Crown Copyright. Licence: 100020999.
 Brighton & Hove City Council, 2012.

Address: Opposite 18 Brunswick
 Square, Hove

Reason: Bay being removed as no
 longer required

CITY INFRASTRUCTURE	PARKING INFRASTRUCTURE
Scale : N.T.S.	 Brighton & Hove
Date : March 2013	
Drawn : DLA	
Drawing Number : B&H_DPB-051-2013	




Key
 Removal of Disabled
 Parking Bay —

© Crown Copyright. Licence: 100020999.
 Brighton & Hove City Council, 2012.

Address: Opposite 42 Brunswick Square, Hove
Reason: Bay being removed as no longer required


CITY INFRASTRUCTURE	PARKING INFRASTRUCTURE
Scale : N.T.S.	 Brighton & Hove
Date : March 2013	
Drawn : DLA	
Drawing Number : B&H_DPB-052-2013	

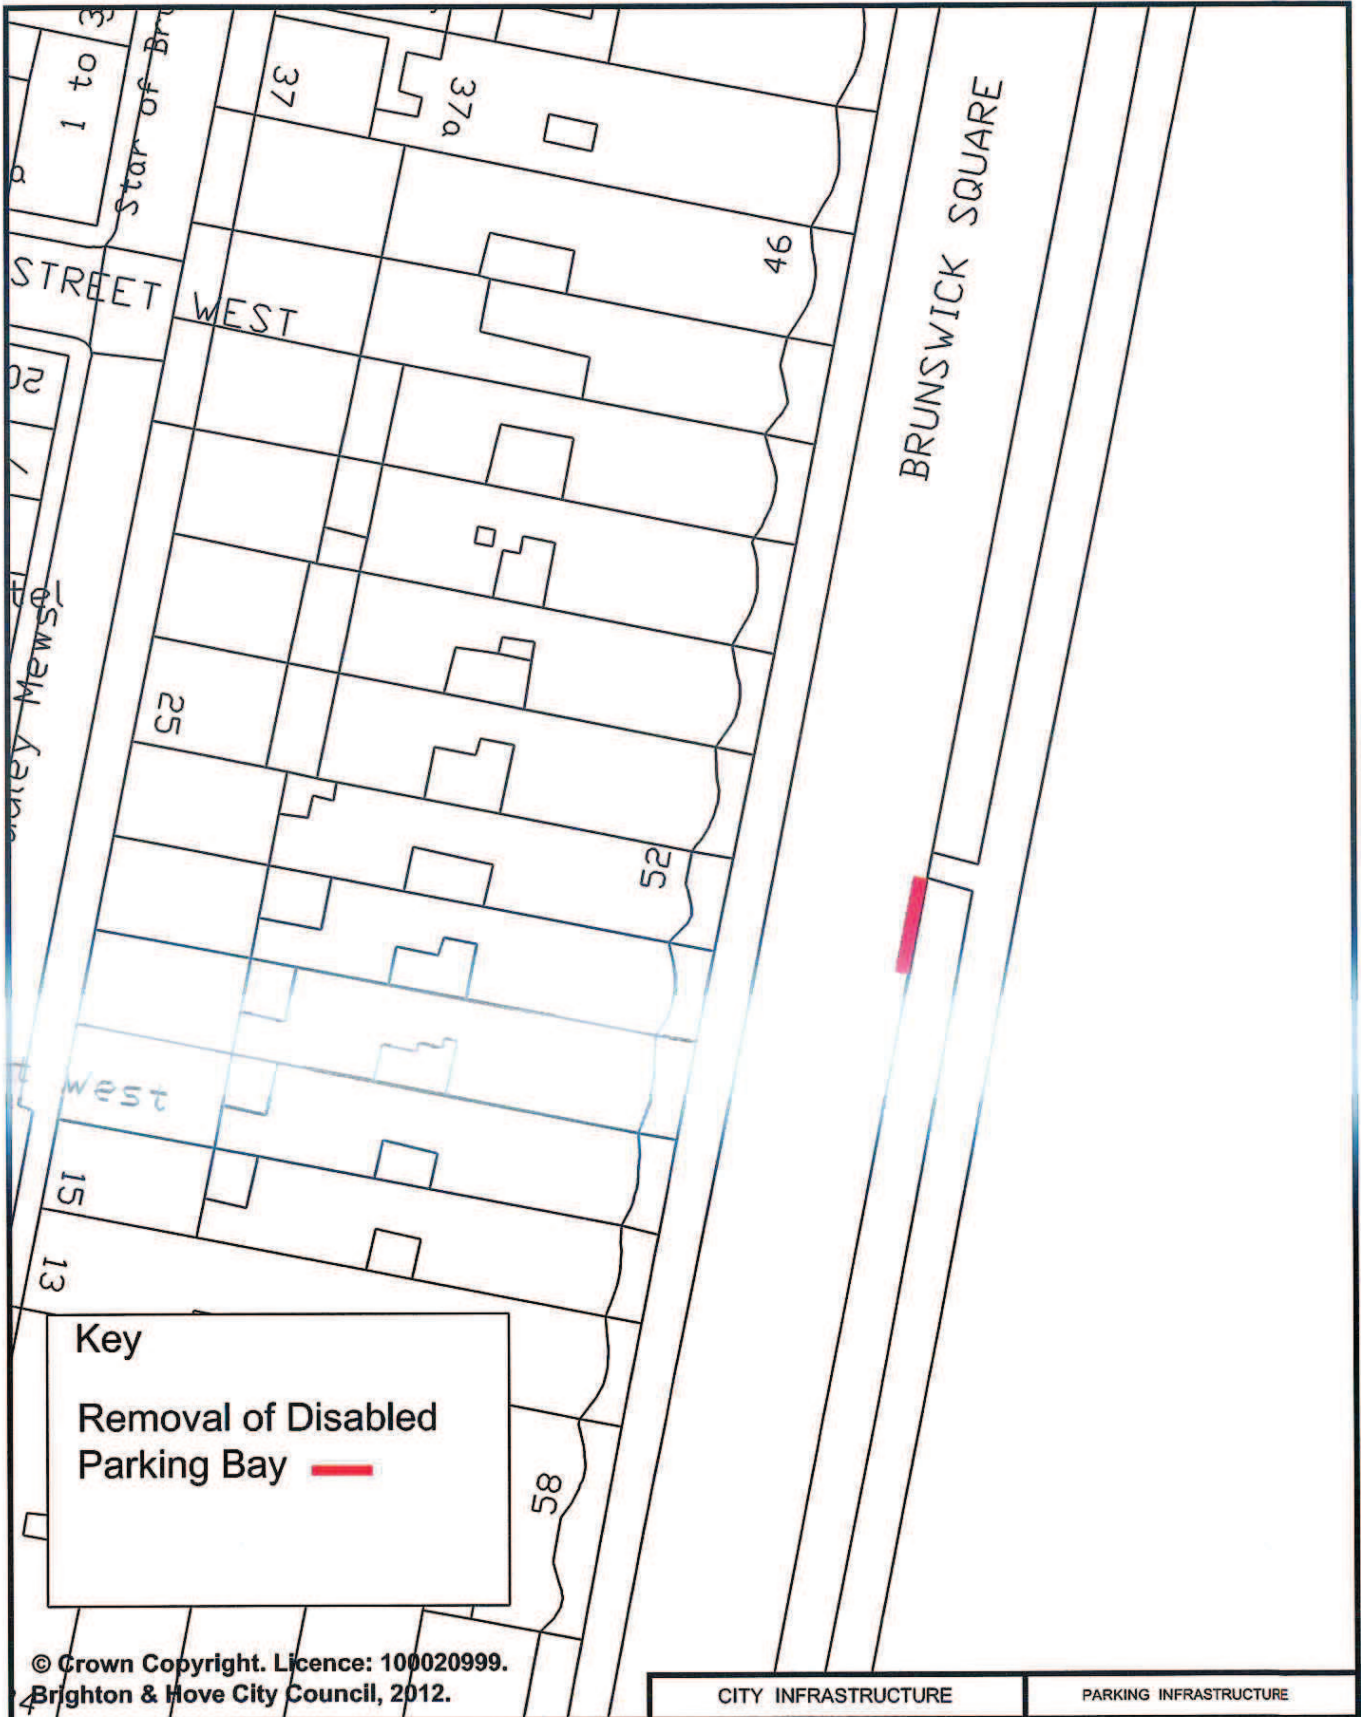


Key
 Removal of Disabled Parking Bay — —

© Crown Copyright. Licence: 100020999.
 Brighton & Hove City Council, 2012.

Address: Opposite 52 Brunswick Square, Hove
Reason: Bay being removed as no longer required

CITY INFRASTRUCTURE	PARKING INFRASTRUCTURE
Scale : N.T.S.	 Brighton & Hove
Date : March 2013	
Drawn : DLA	Brighton & Hove Drawing Number : B&H_DPB-053-2013
Drawing Number : B&H_DPB-053-2013	

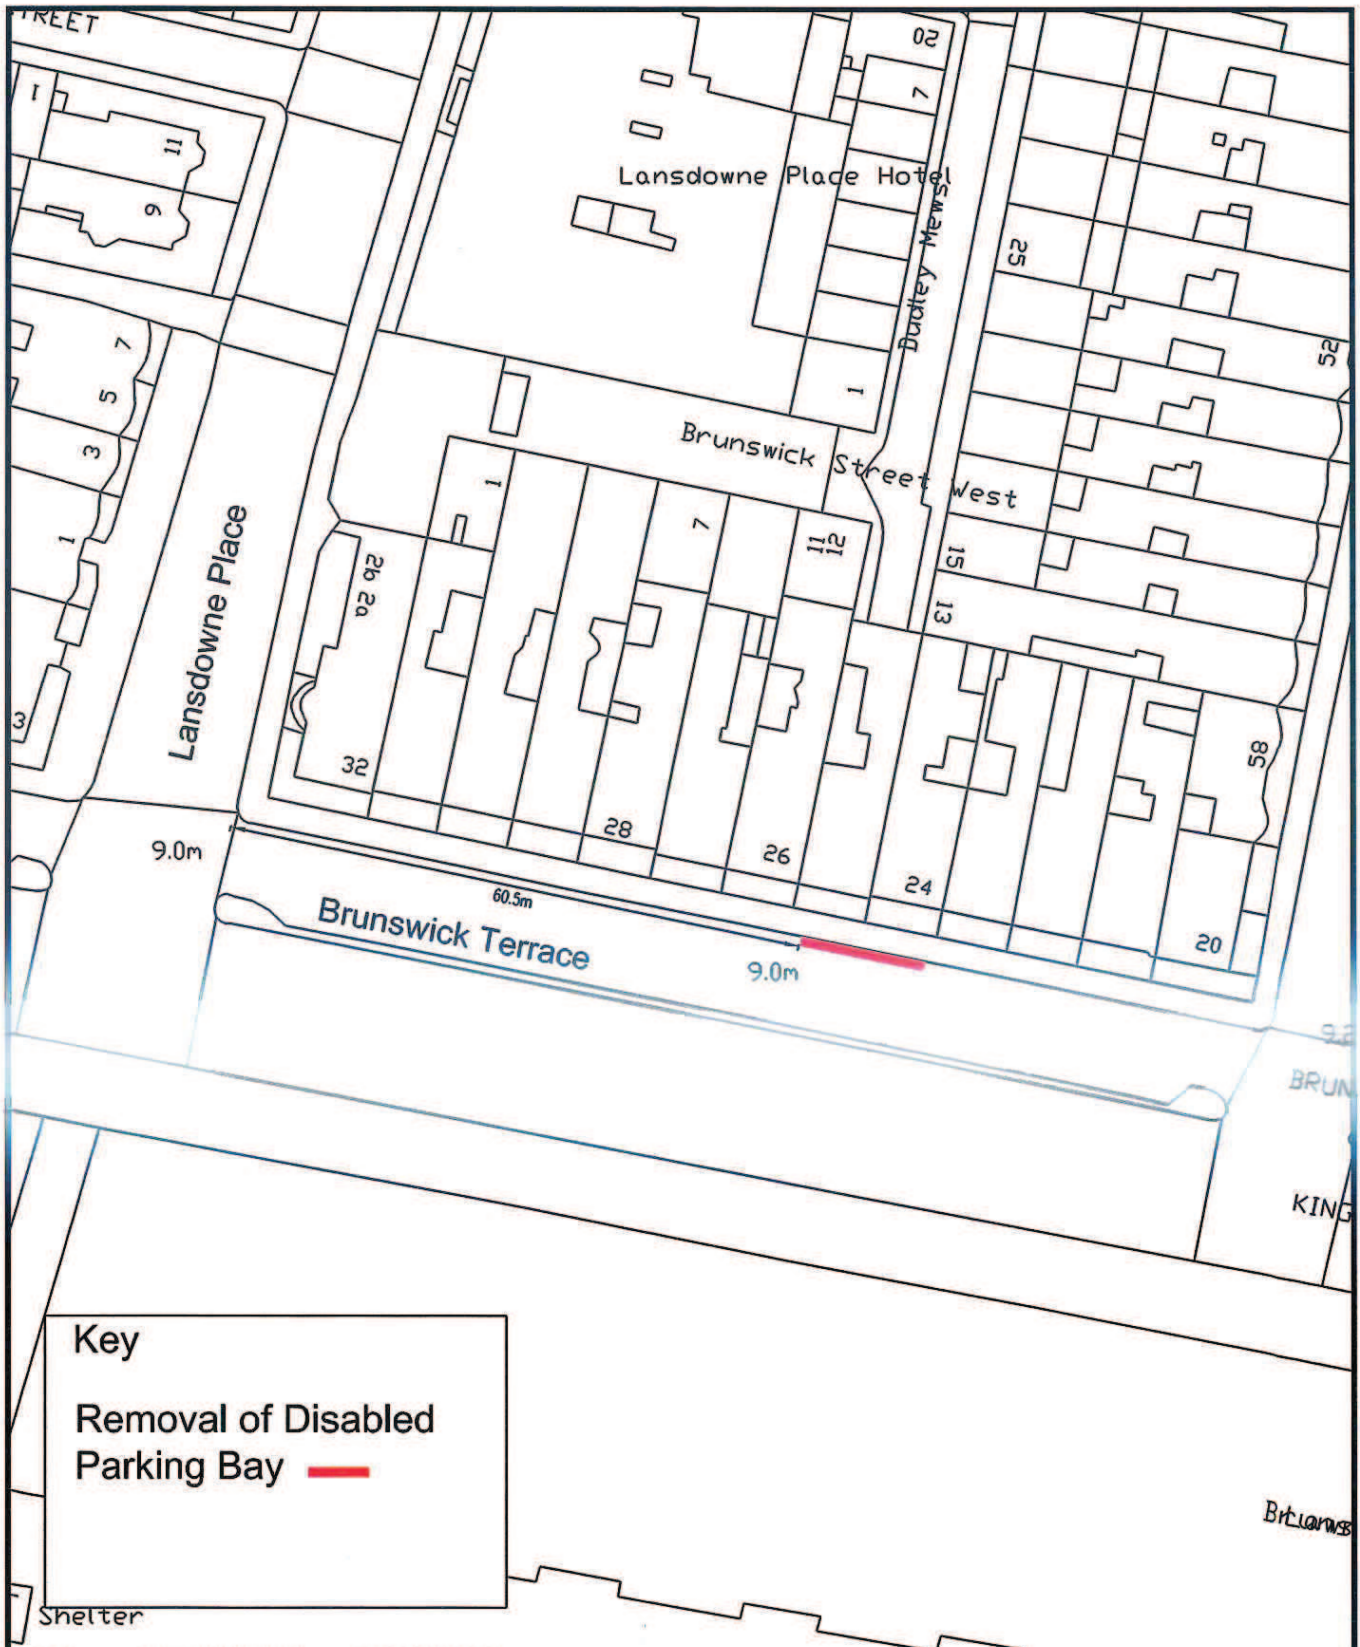


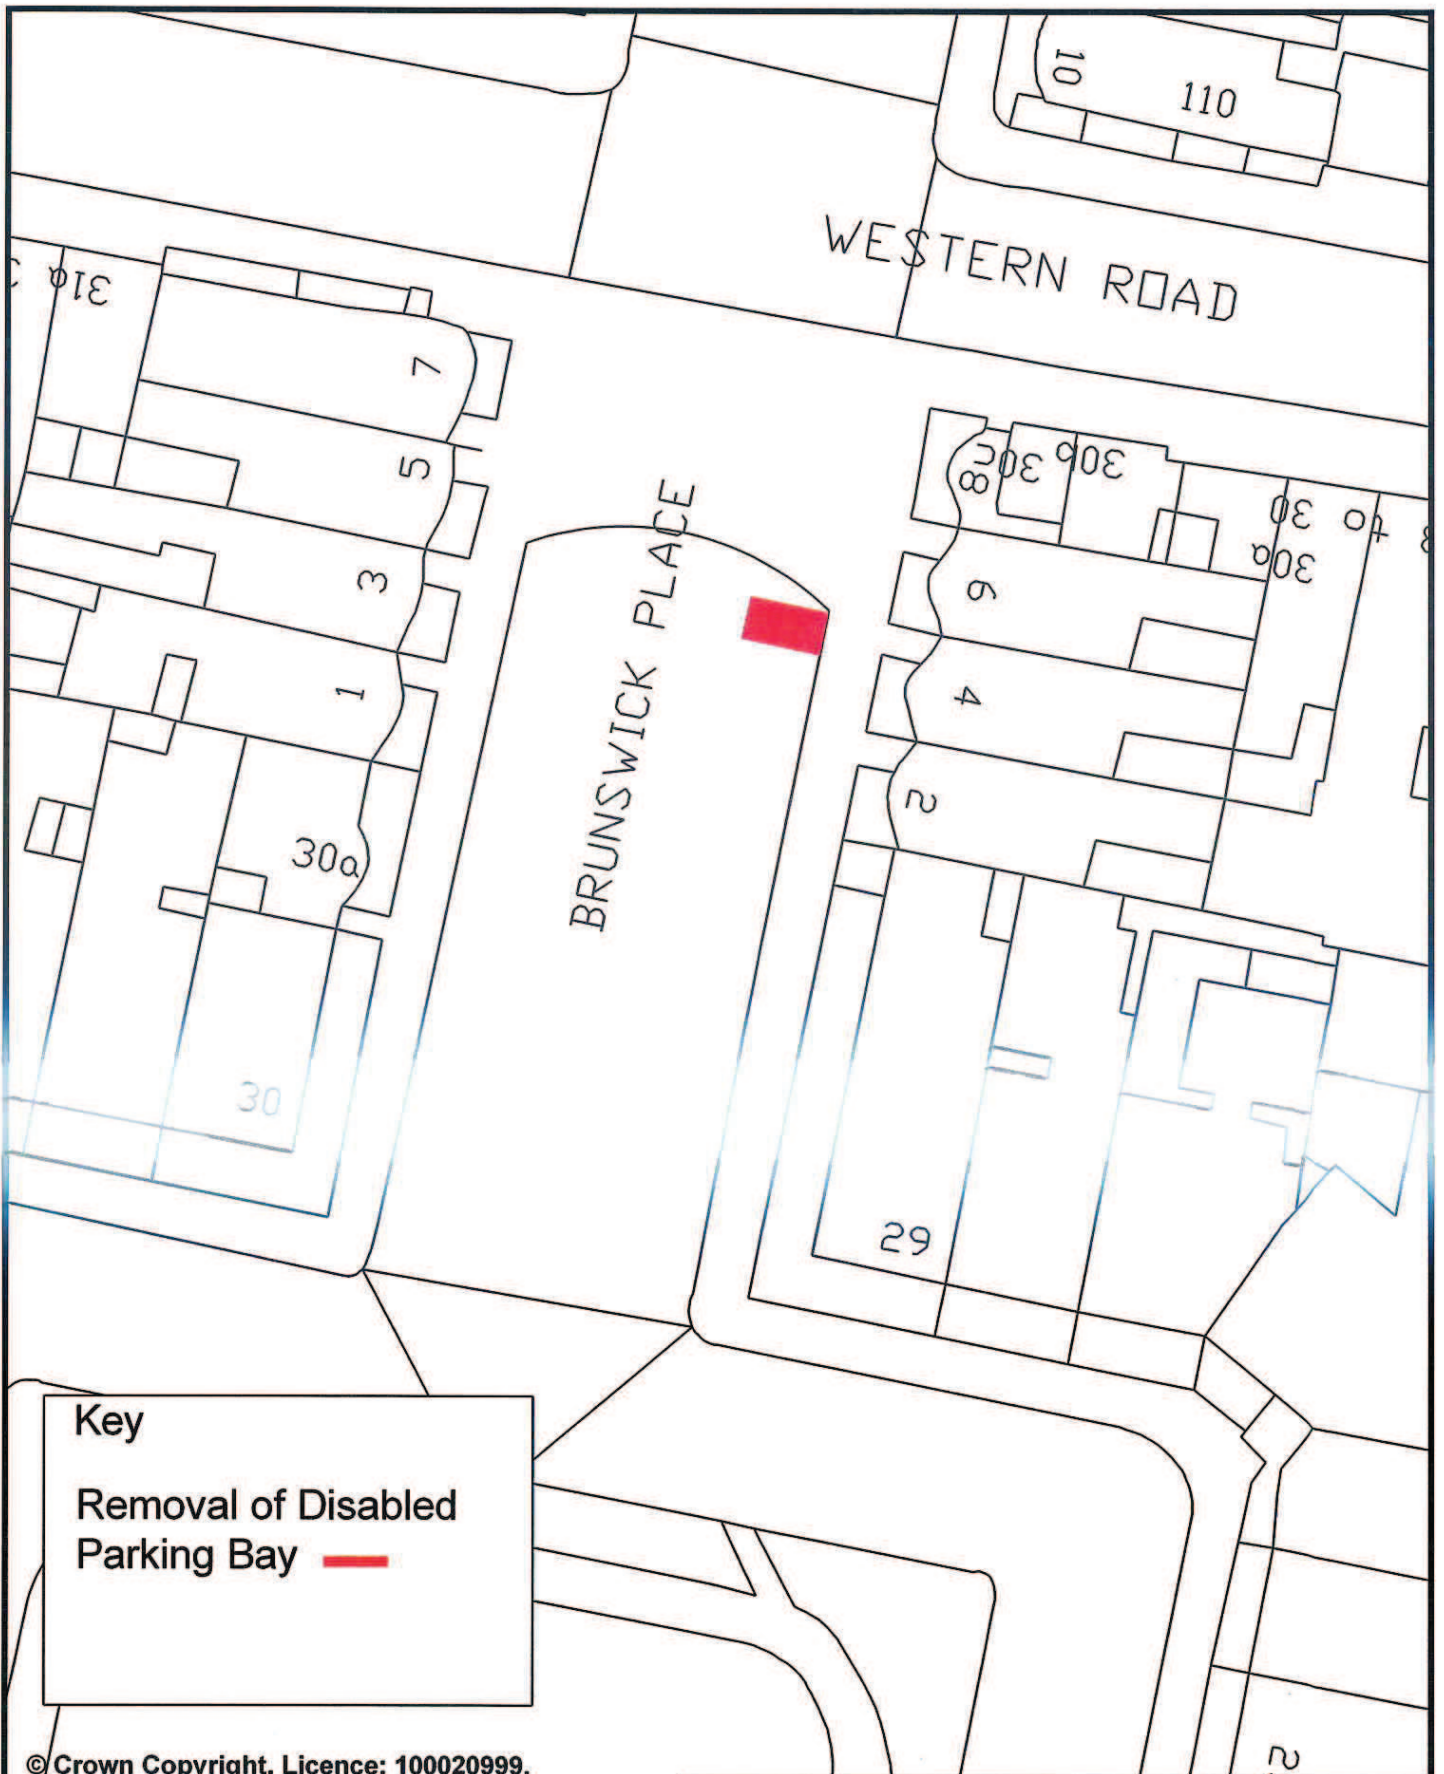
Key
 Removal of Disabled
 Parking Bay —

© Crown Copyright. Licence: 100020999.
 Brighton & Hove City Council, 2012.

Address: 24/25 Brunswick Terrace,
 Hove


Reason: Bays being removed as
 no longer required


CITY INFRASTRUCTURE		PARKING INFRASTRUCTURE
Scale : N.T.S.		 Brighton & Hove
Date : Jan 2013		
Drawn : DLA		Drawing Number : B&H_DPB-004-2013
Drawing Number : B&H_DPB-004-2013		



Key
 Removal of Disabled
 Parking Bay ■

© Crown Copyright. Licence: 100020999.
 Brighton & Hove City Council, 2012.

	CITY INFRASTRUCTURE	PARKING INFRASTRUCTURE
Address: 4 Brunswick Place, Hove	Scale : N.T.S.	 Brighton & Hove
	Date : April 2013	
Reason: Bay being removed as no longer required	Drawn : DLA	
	Drawing Number : B&H_DPB-089-2013	

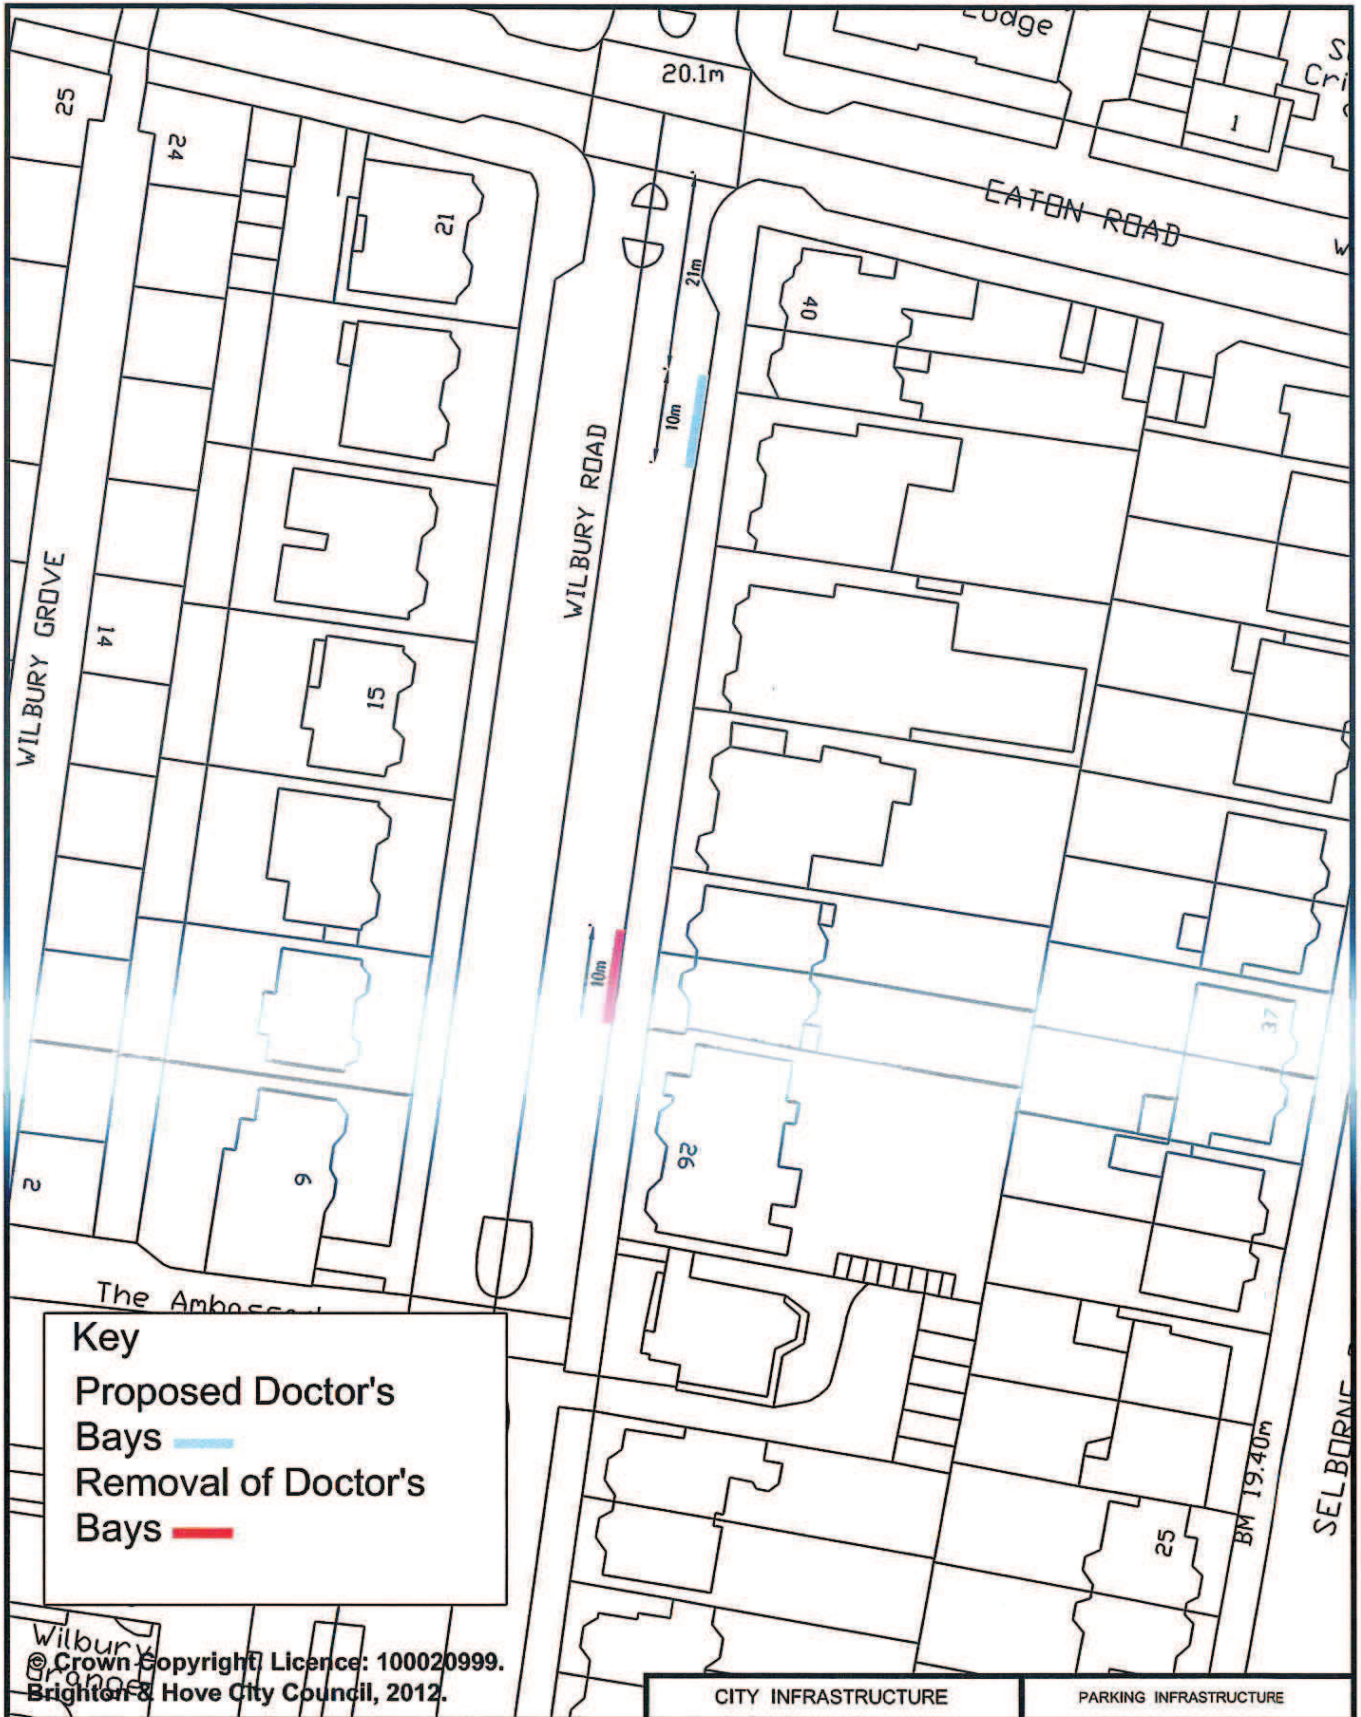


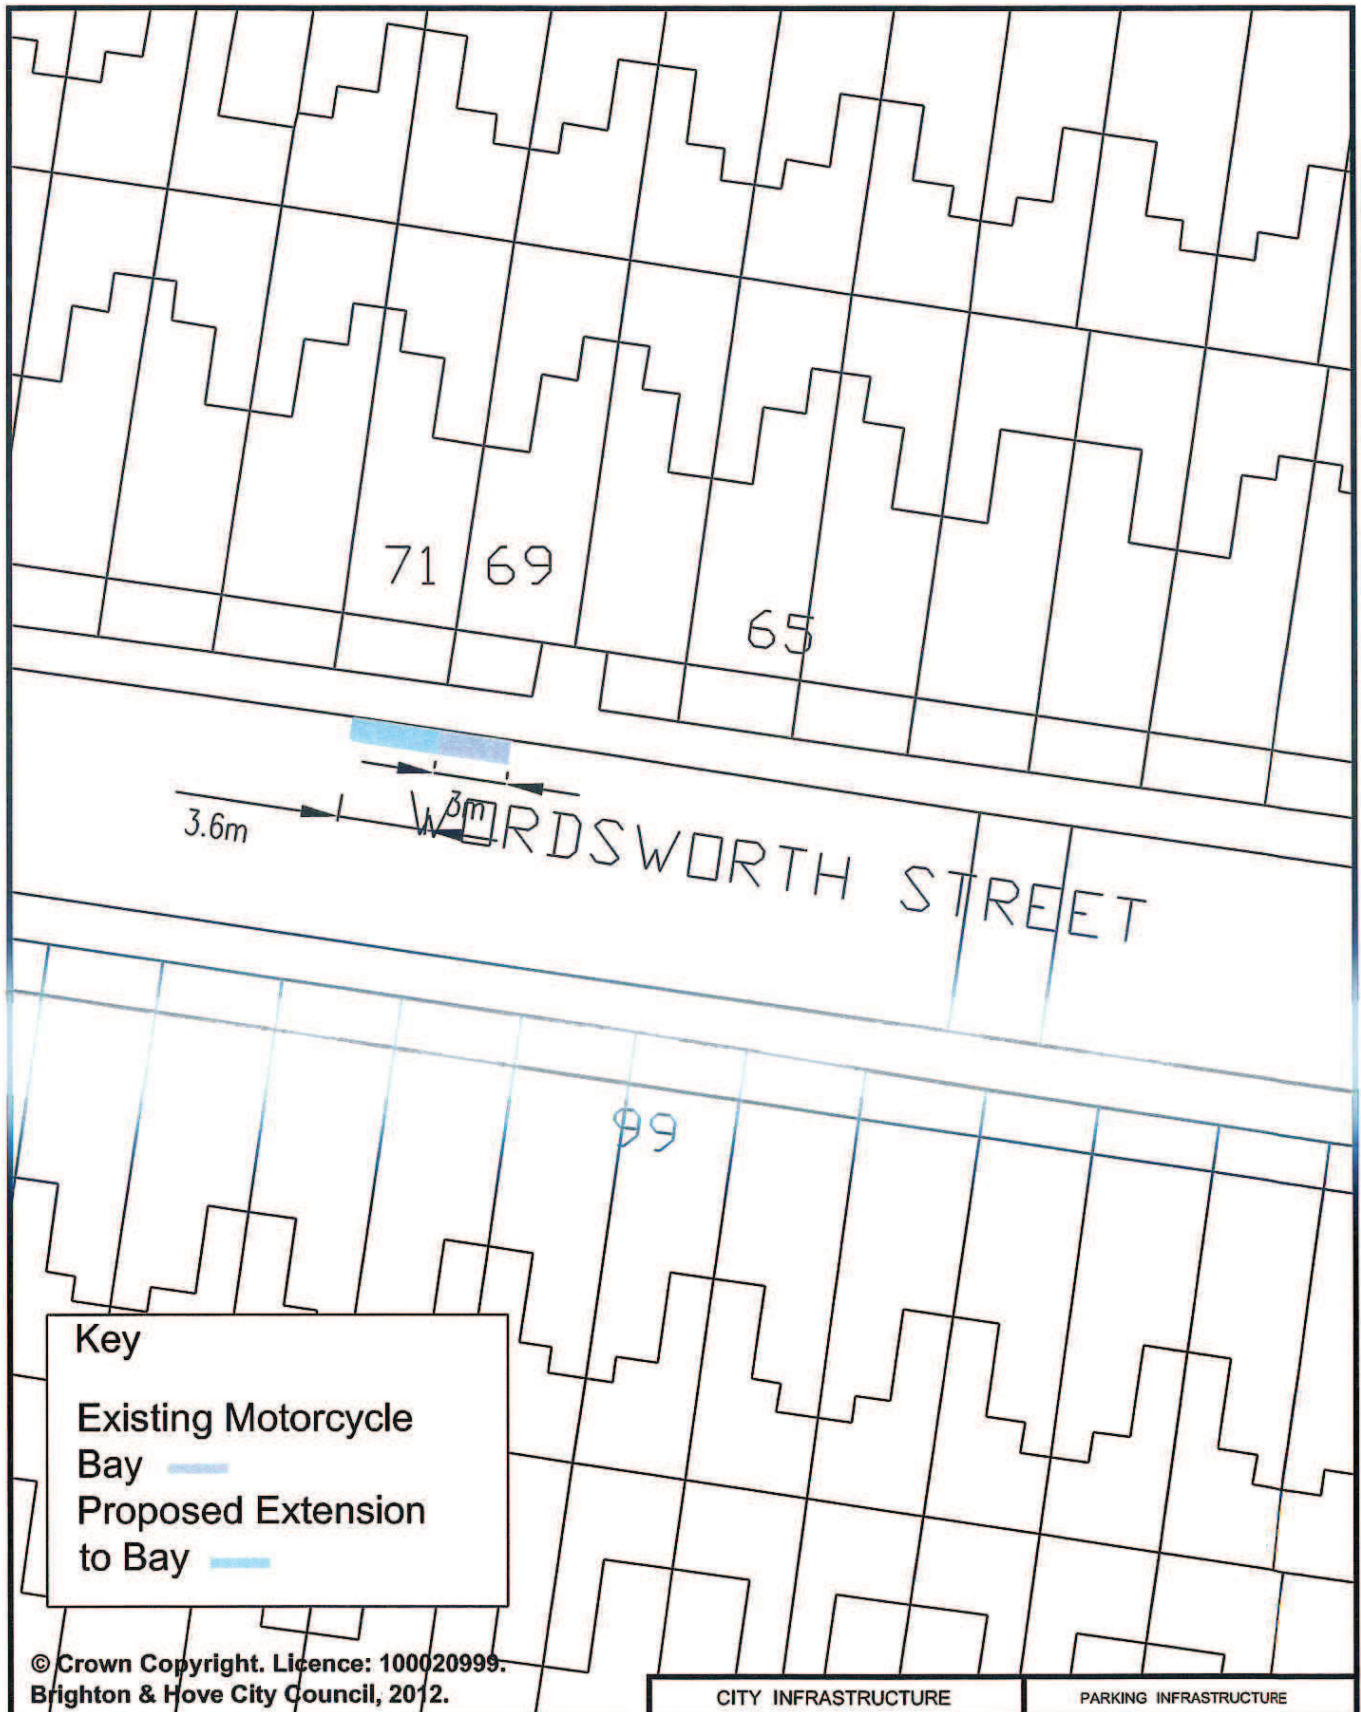
Key
 Proposed Doctor's Bays ——— (blue line)
 Removal of Doctor's Bays ——— (red line)

© Crown Copyright Licence: 100020999.
 Brighton & Hove City Council, 2012.

Address: Wilbury Road, Hove

Reason: Relocating Doctor's bays to a more suitable location


CITY INFRASTRUCTURE		PARKING INFRASTRUCTURE	
Scale : N.T.S.		 Brighton & Hove	
Date : May 2013			
Drawn : D.A.		Drawing Number :B&H_DOC-01-2013	




© Crown Copyright. Licence: 100020999.
Brighton & Hove City Council, 2012.


Address: Wordsworth Street,
Hove


Reason: To provide additional
parking for motorcycles

CITY INFRASTRUCTURE	PARKING INFRASTRUCTURE
Scale : N.T.S.	 Brighton & Hove
Date : May 2013	
Drawn : D.A.	Drawing Number : B&H_M/C-18-2013

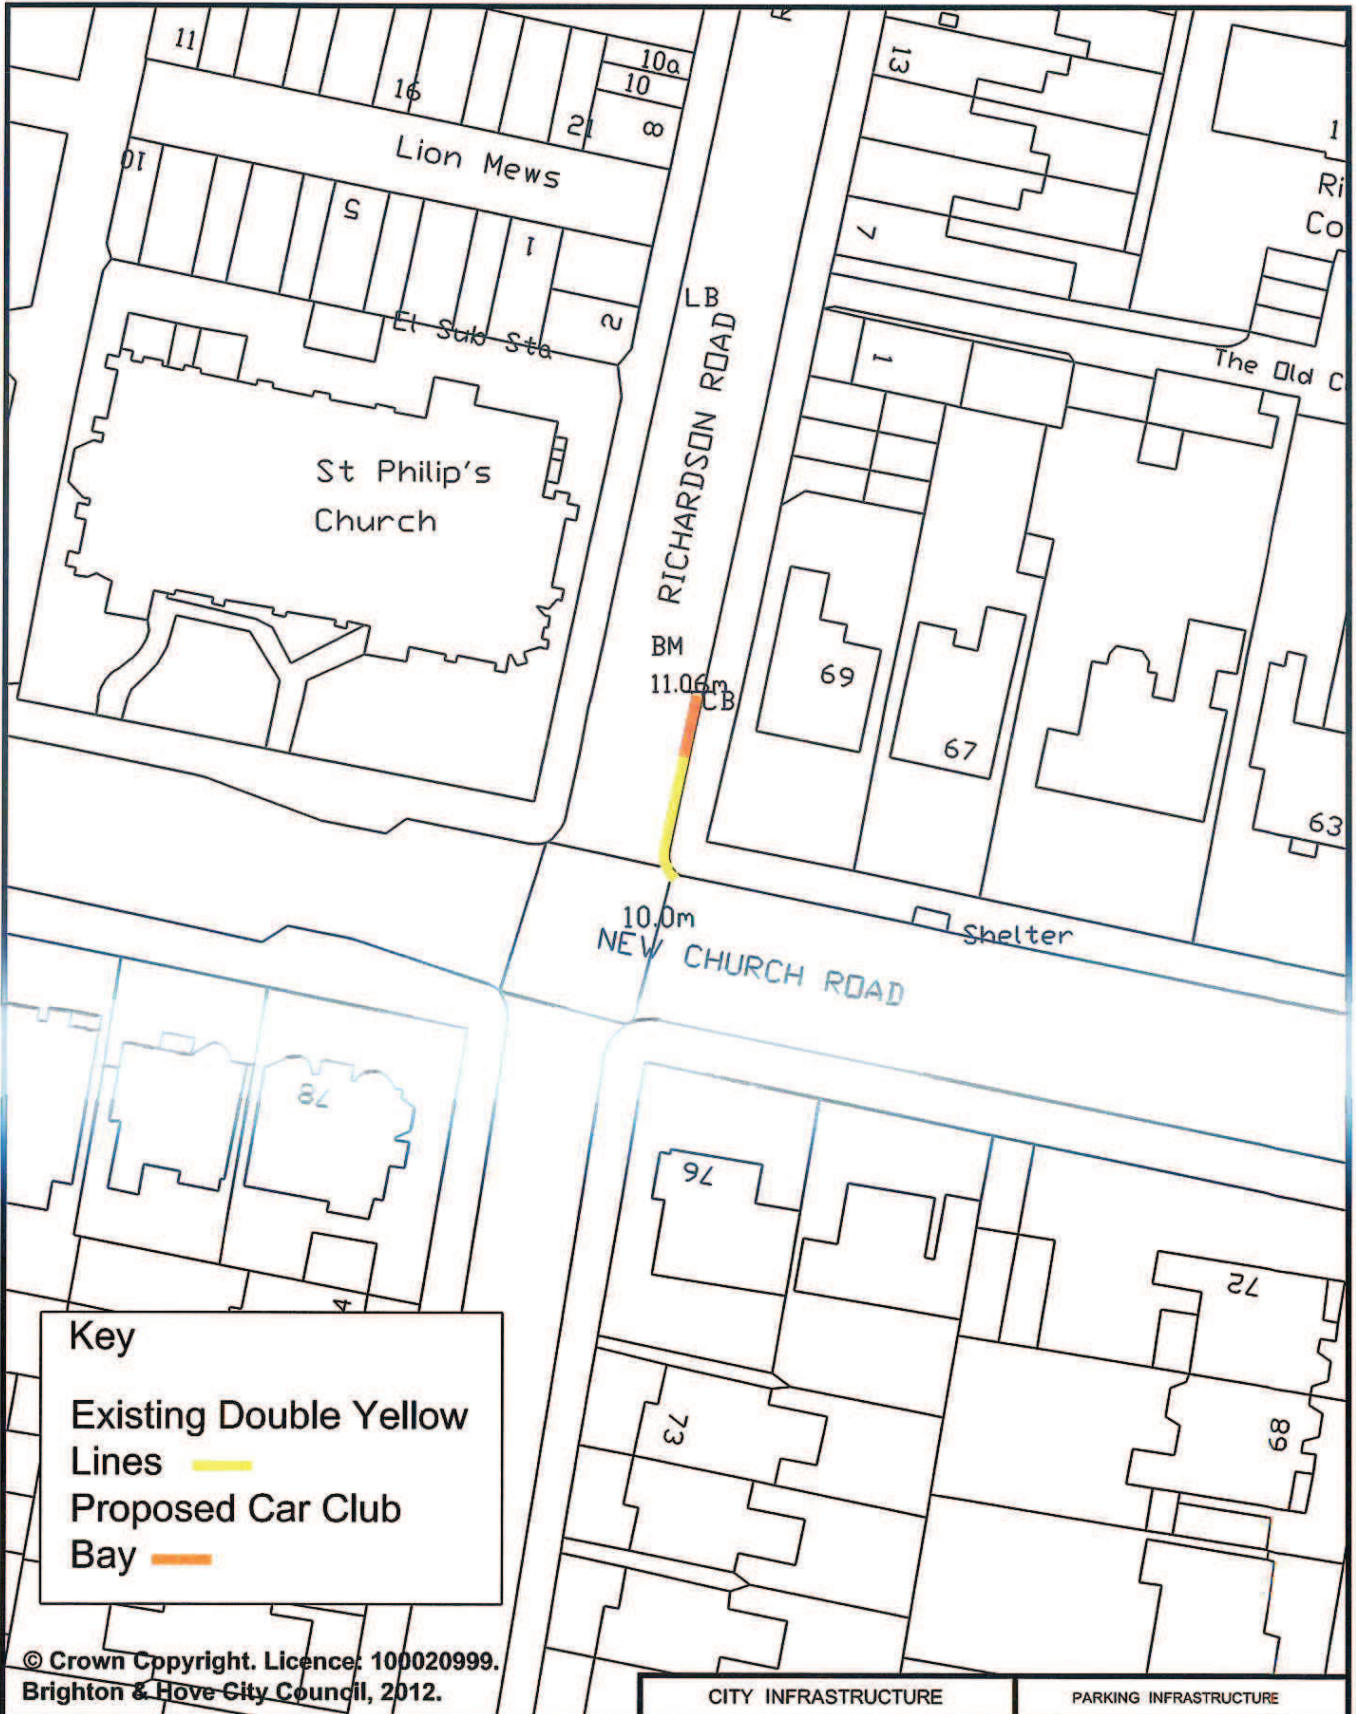

Key


Existing Double Yellow Lines 


Proposed Car Club Bay 

© Crown Copyright. Licence: 100020999.
Brighton & Hove City Council, 2012.

Address: Richardson Road, Hove

Reason: To provide designated bay for Car Club Operators

CITY INFRASTRUCTURE	PARKING INFRASTRUCTURE
Scale : N.T.S.	
Date : May 2013	
Drawn : D.A.	Brighton & Hove
Drawing Number : B&H_CC-02-2013	

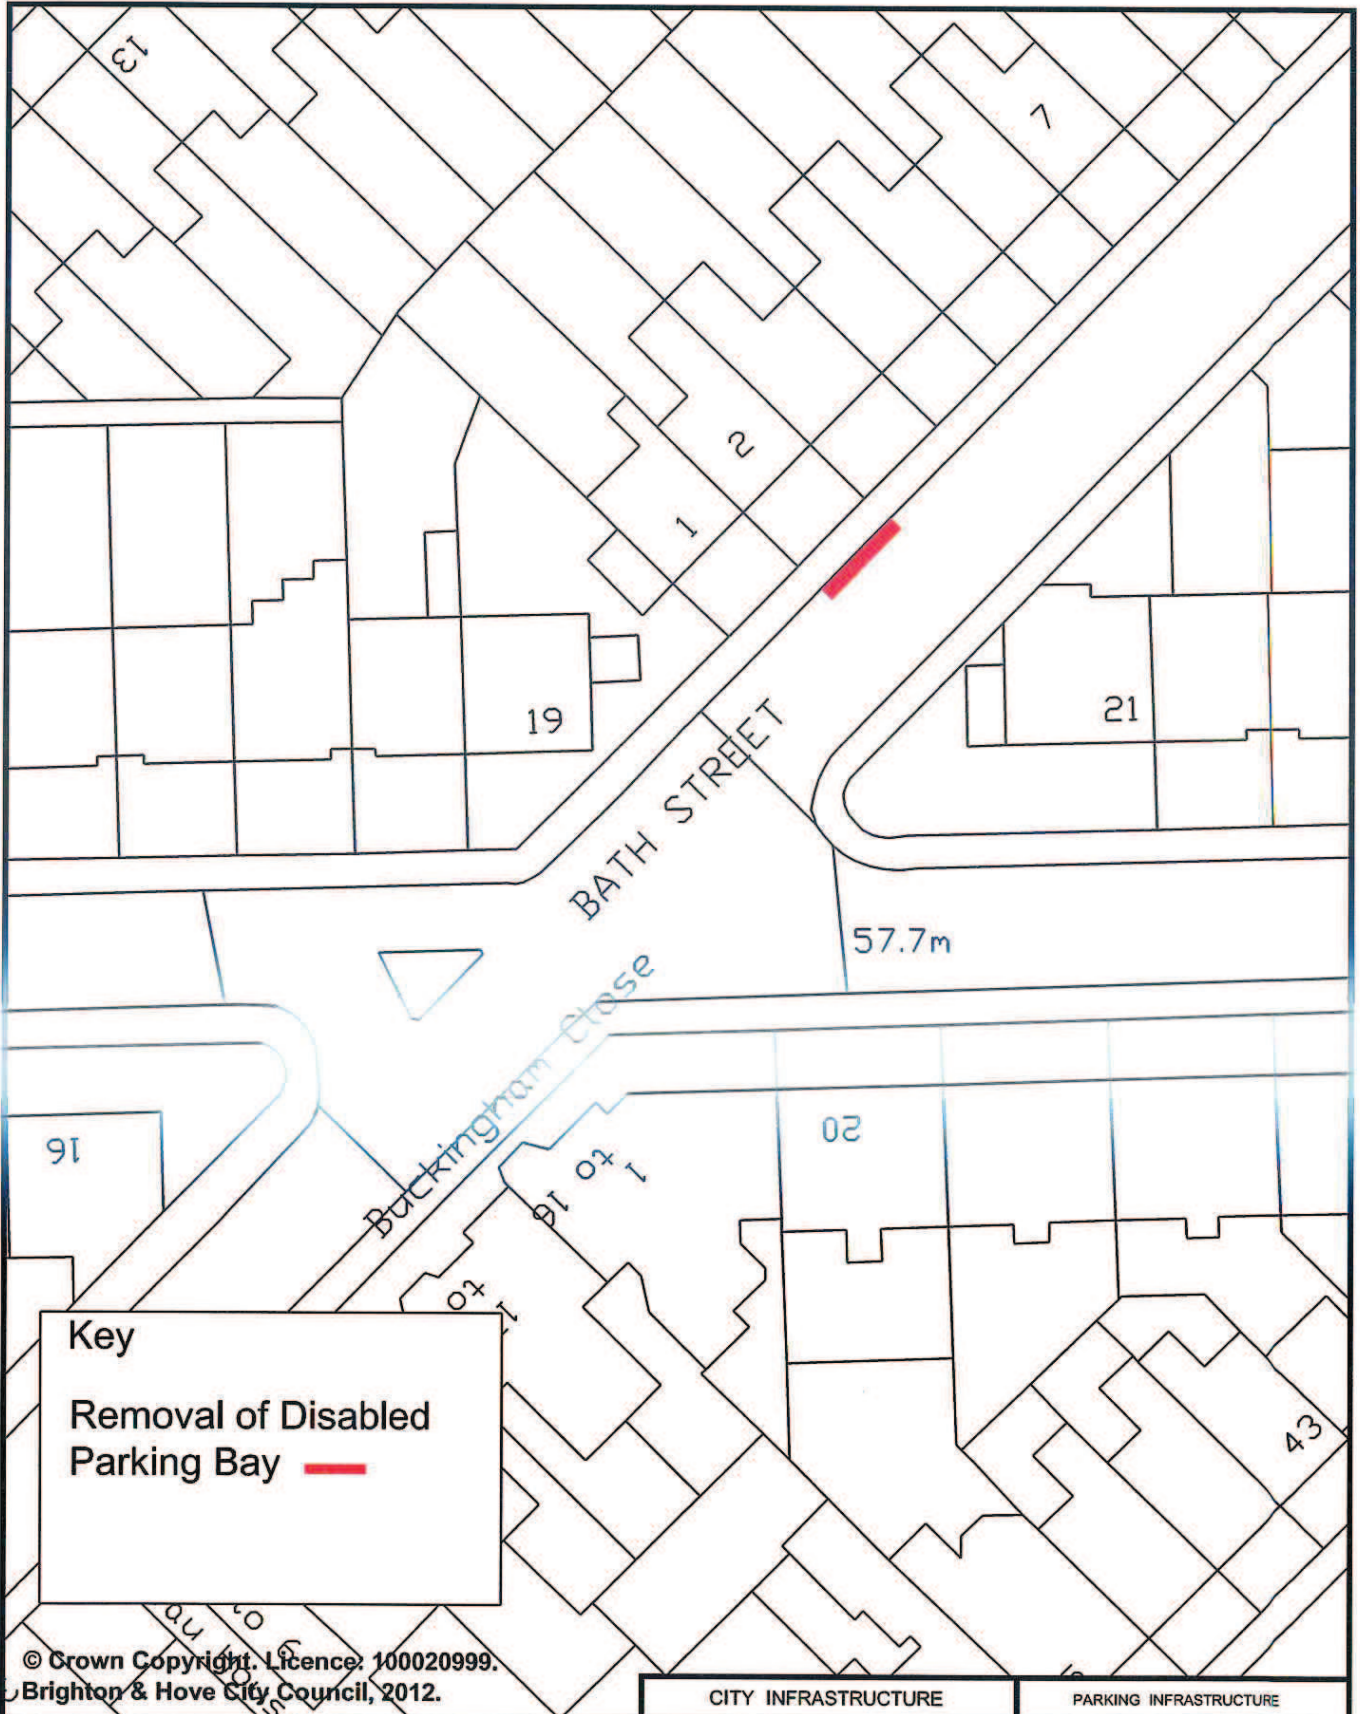

Key
 Removal of Disabled
 Parking Bay —

© Crown Copyright. Licence: 100020999.
 Brighton & Hove City Council, 2012.

Address: 2 Bath Street, Brighton
Reason: Bay being removed as no longer required

CITY INFRASTRUCTURE	PARKING INFRASTRUCTURE
Scale : N.T.S.	 Brighton & Hove
Date : April 2013	
Drawn : DLA	
Drawing Number : B&H_DPB-066-2013	